

Basement Project Image 1

Full Bathroom  
behind rectangular  
highlight. Custom door  
made of Wood &  
Glass.

**APPROVED**

11/02/2017

**This is a Revit rendering of a basement project. I uploaded into Bluebeam Revu pdf viewer. Marked it up with a question, comments, dimension details, approved stamp and a watermark for collaboration with others .**


**This is just a sample of my Bluebeam knowledge and use.**


This is a custom sliding panel door that will meet flush with stair stringer.  
(Panel is covered Chevron pattern w tile)

Wall behind panel door can also be seen with half stone and upper half in painted green with a painting of camera. This is a partition wall to hide mechanical HVAC.

[linkedin.com/in/wadyth-z-450398101](https://www.linkedin.com/in/wadyth-z-450398101)

Revit customized template using marble tile & wooden floor images at different scales.

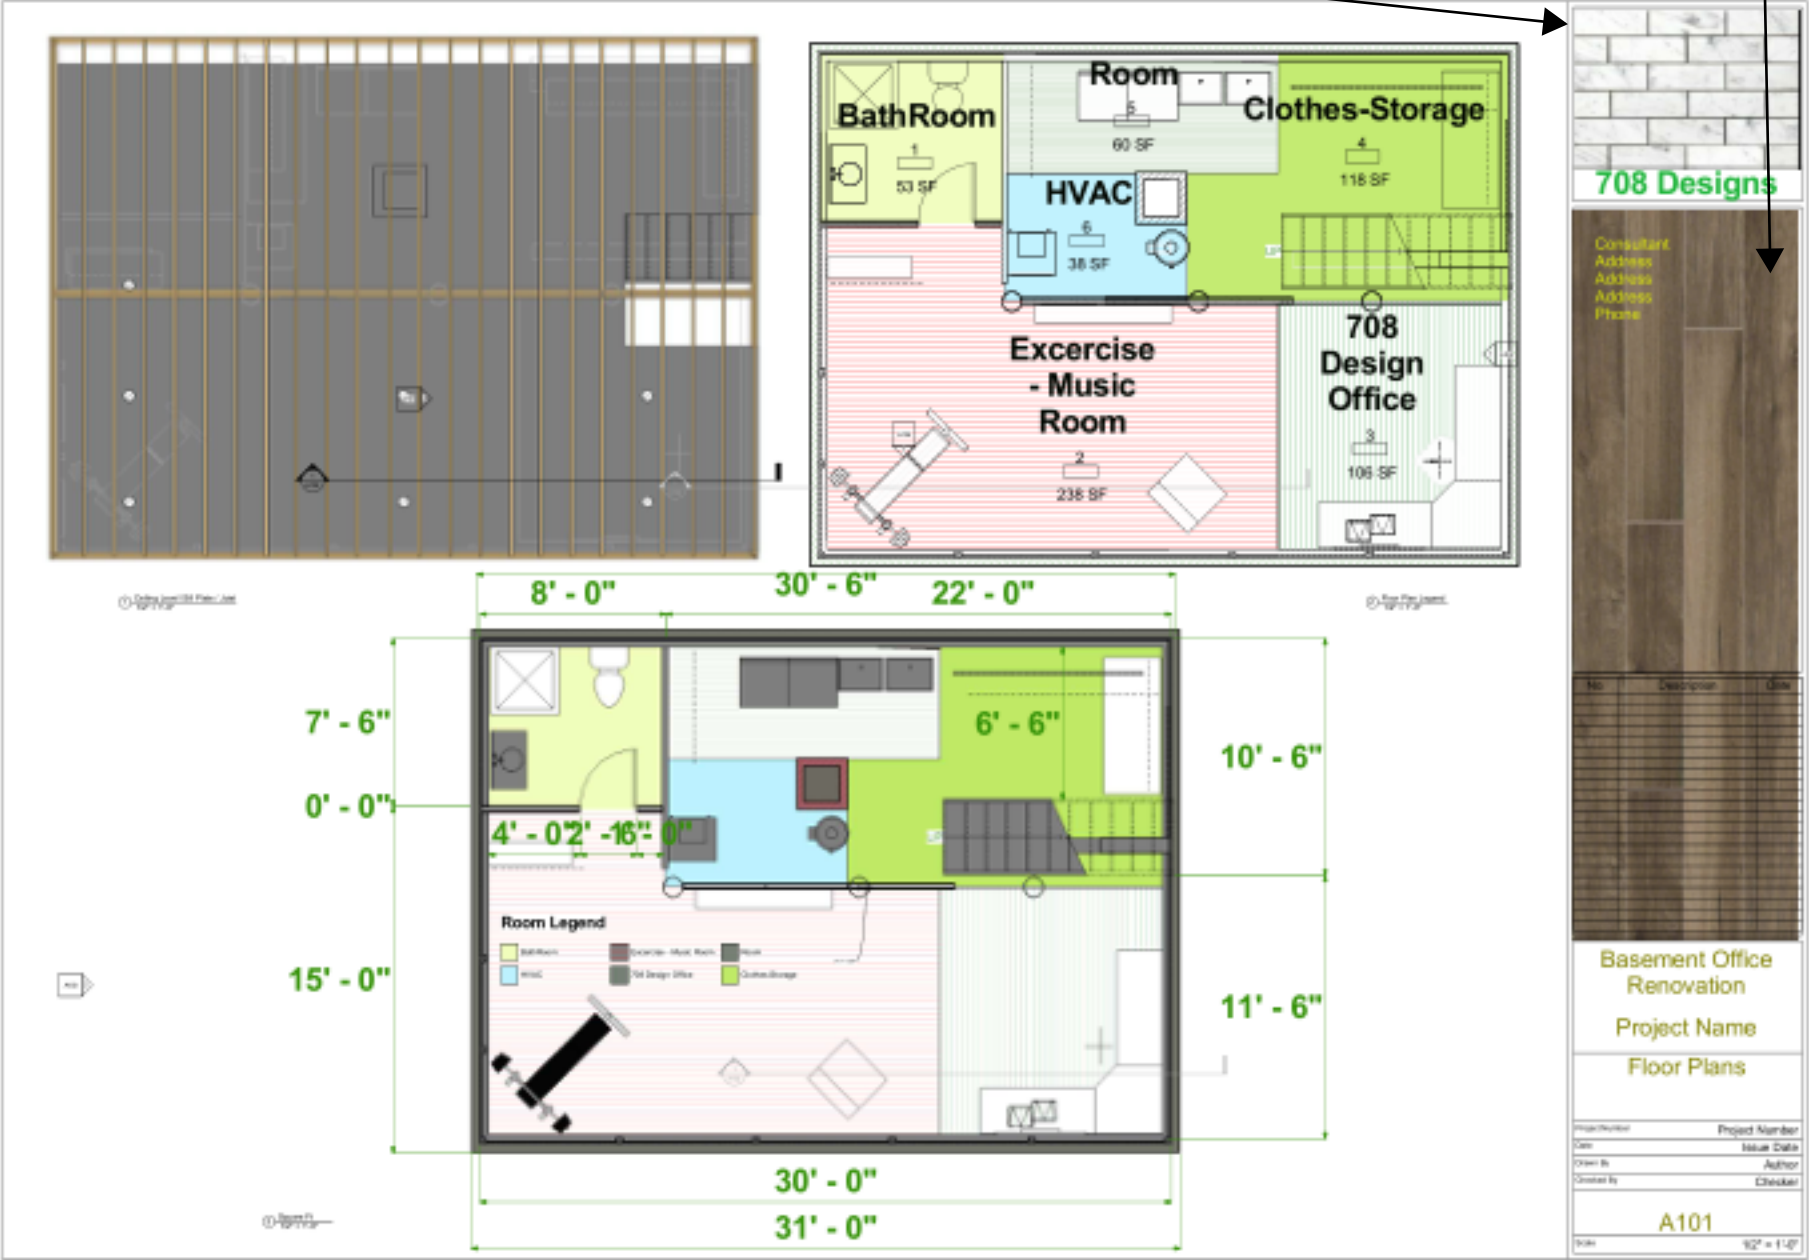

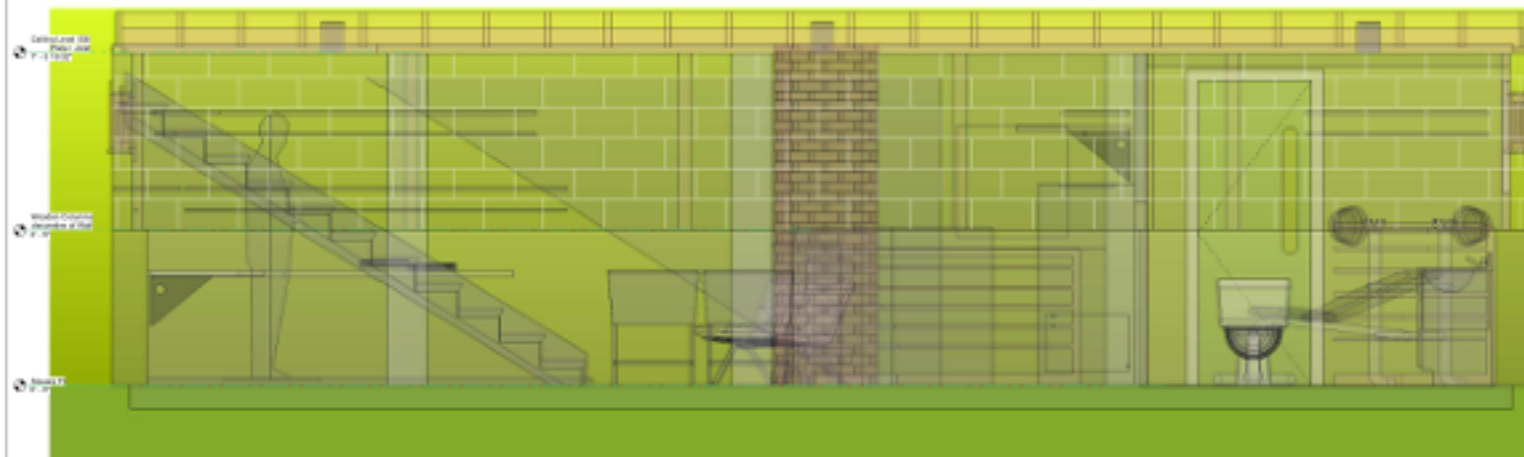

1-100



708 Designs

Consultant  
Address  
Address  
Address  
Phone

No.	Description	Qty
1	1	1
2	2	2
3	3	3
100	100	100

Basement Office  
Renovation

Project Name

North & South  
Green Gradient

Project Number	Project Number
Date	Issue Date
Client No.	Author
Client No.	Checker

A104


Scale 1" = 1'-0"










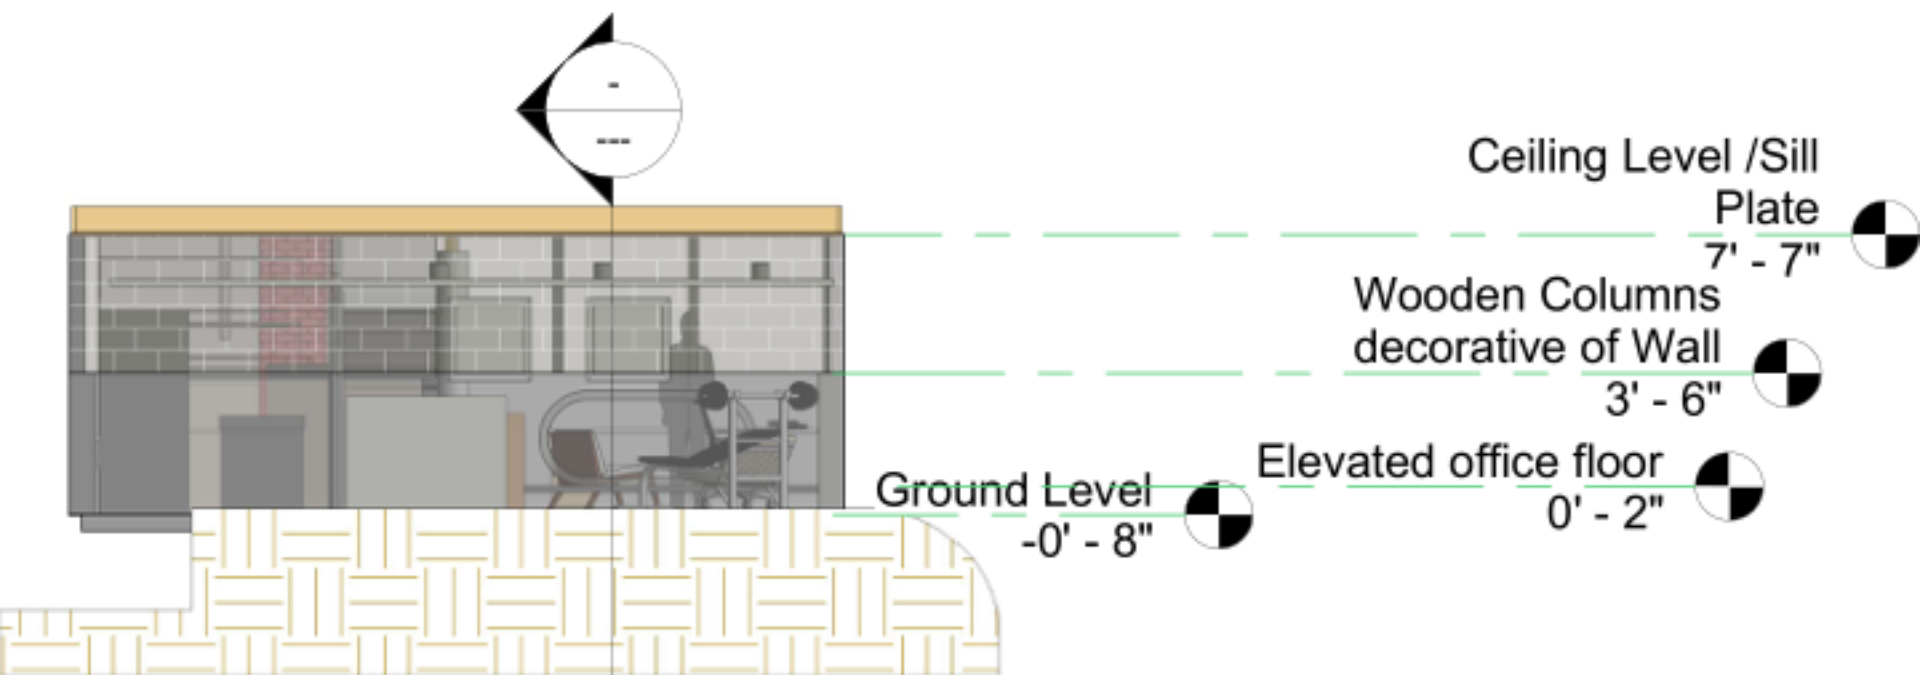


Customized Section  
Arrow Heads in Revit  
overly scaled for this  
drawing.

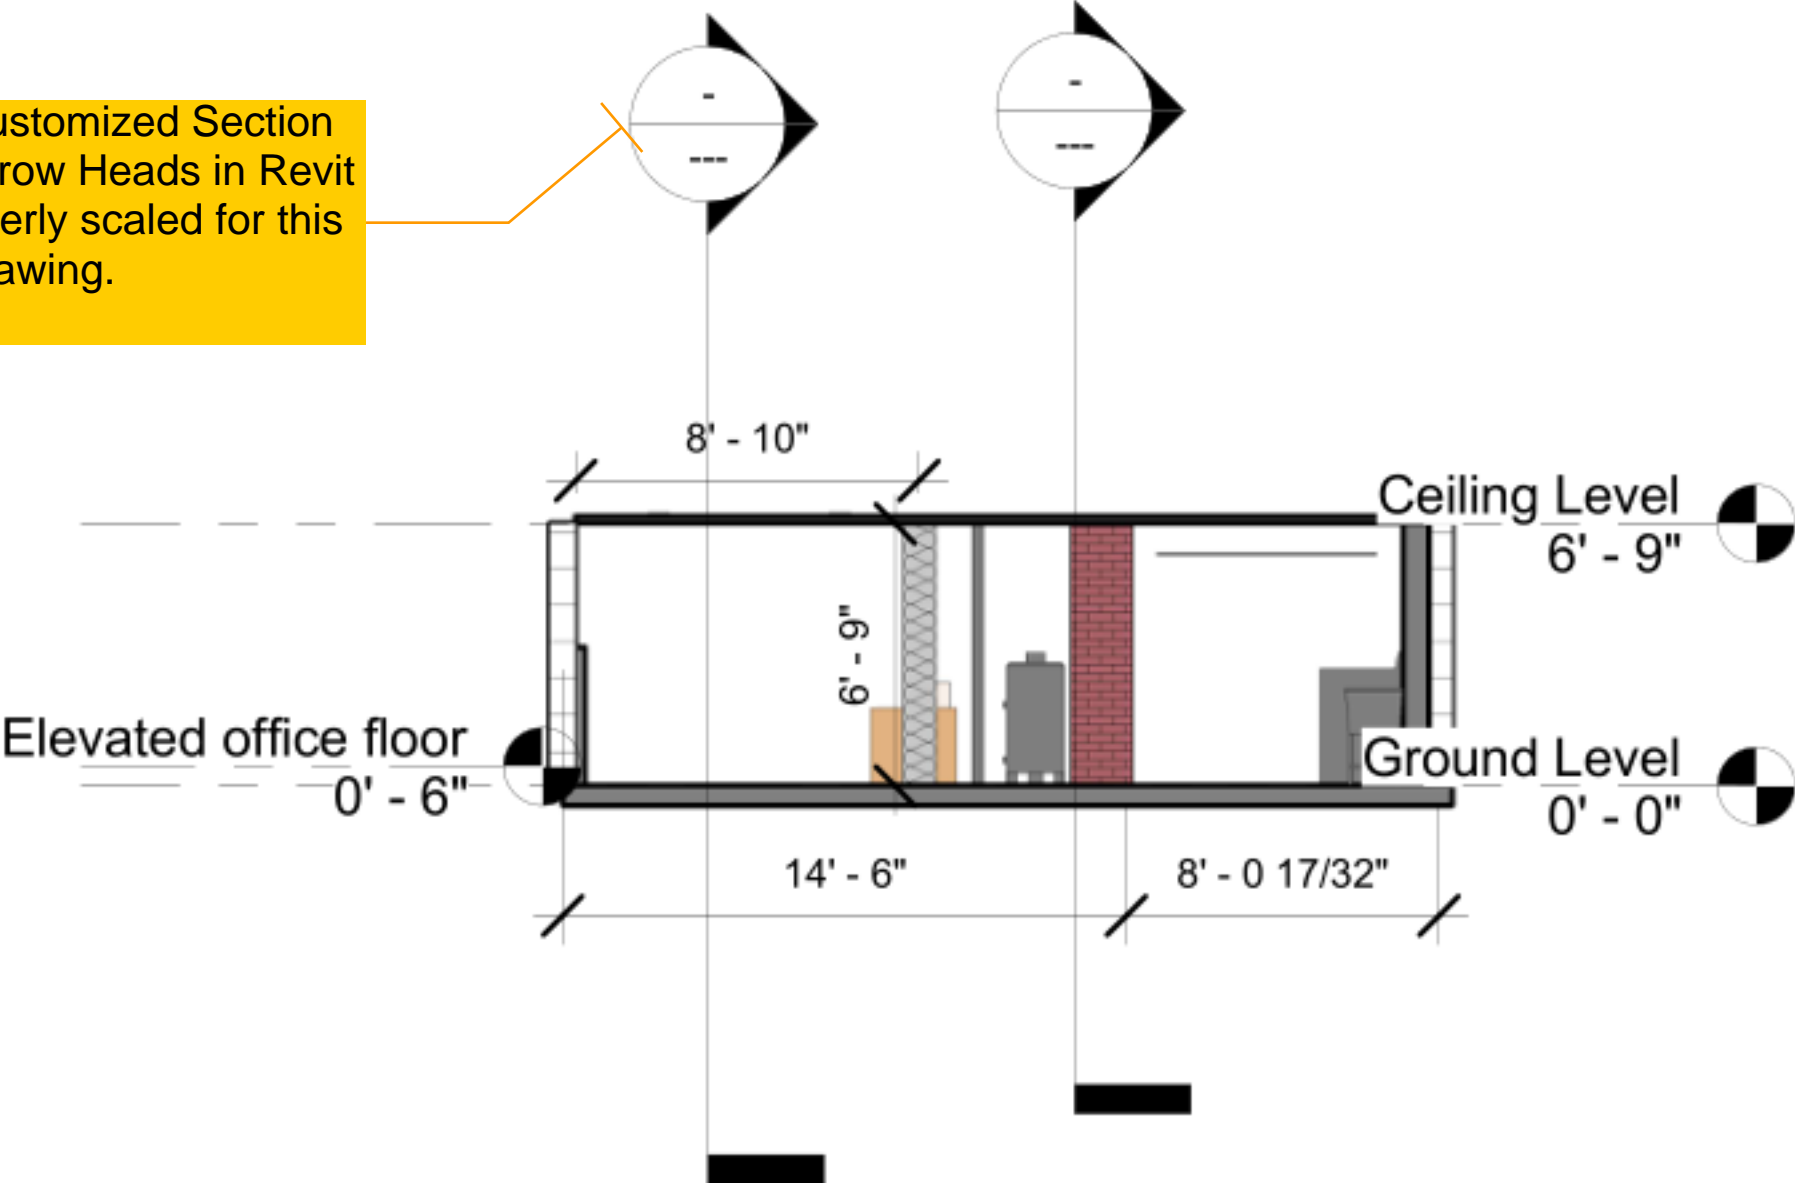



Customized Elevation Markers  
& Font in Revit ( a bit  
overscaled for this drawing)

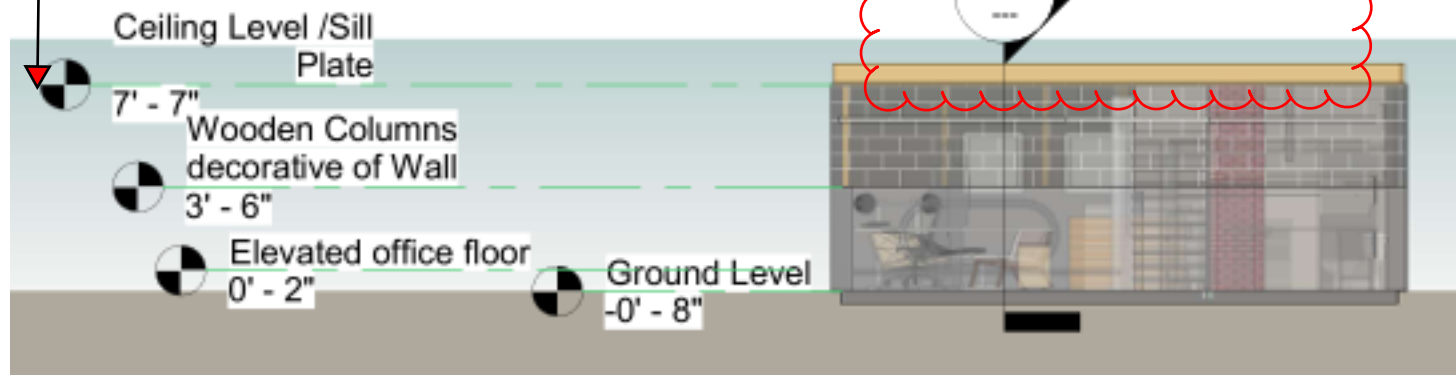

Can you please revise  
the scale on this section  
marker or overall  
drawing.  
Thanks

